


APPROVAL COLUMN

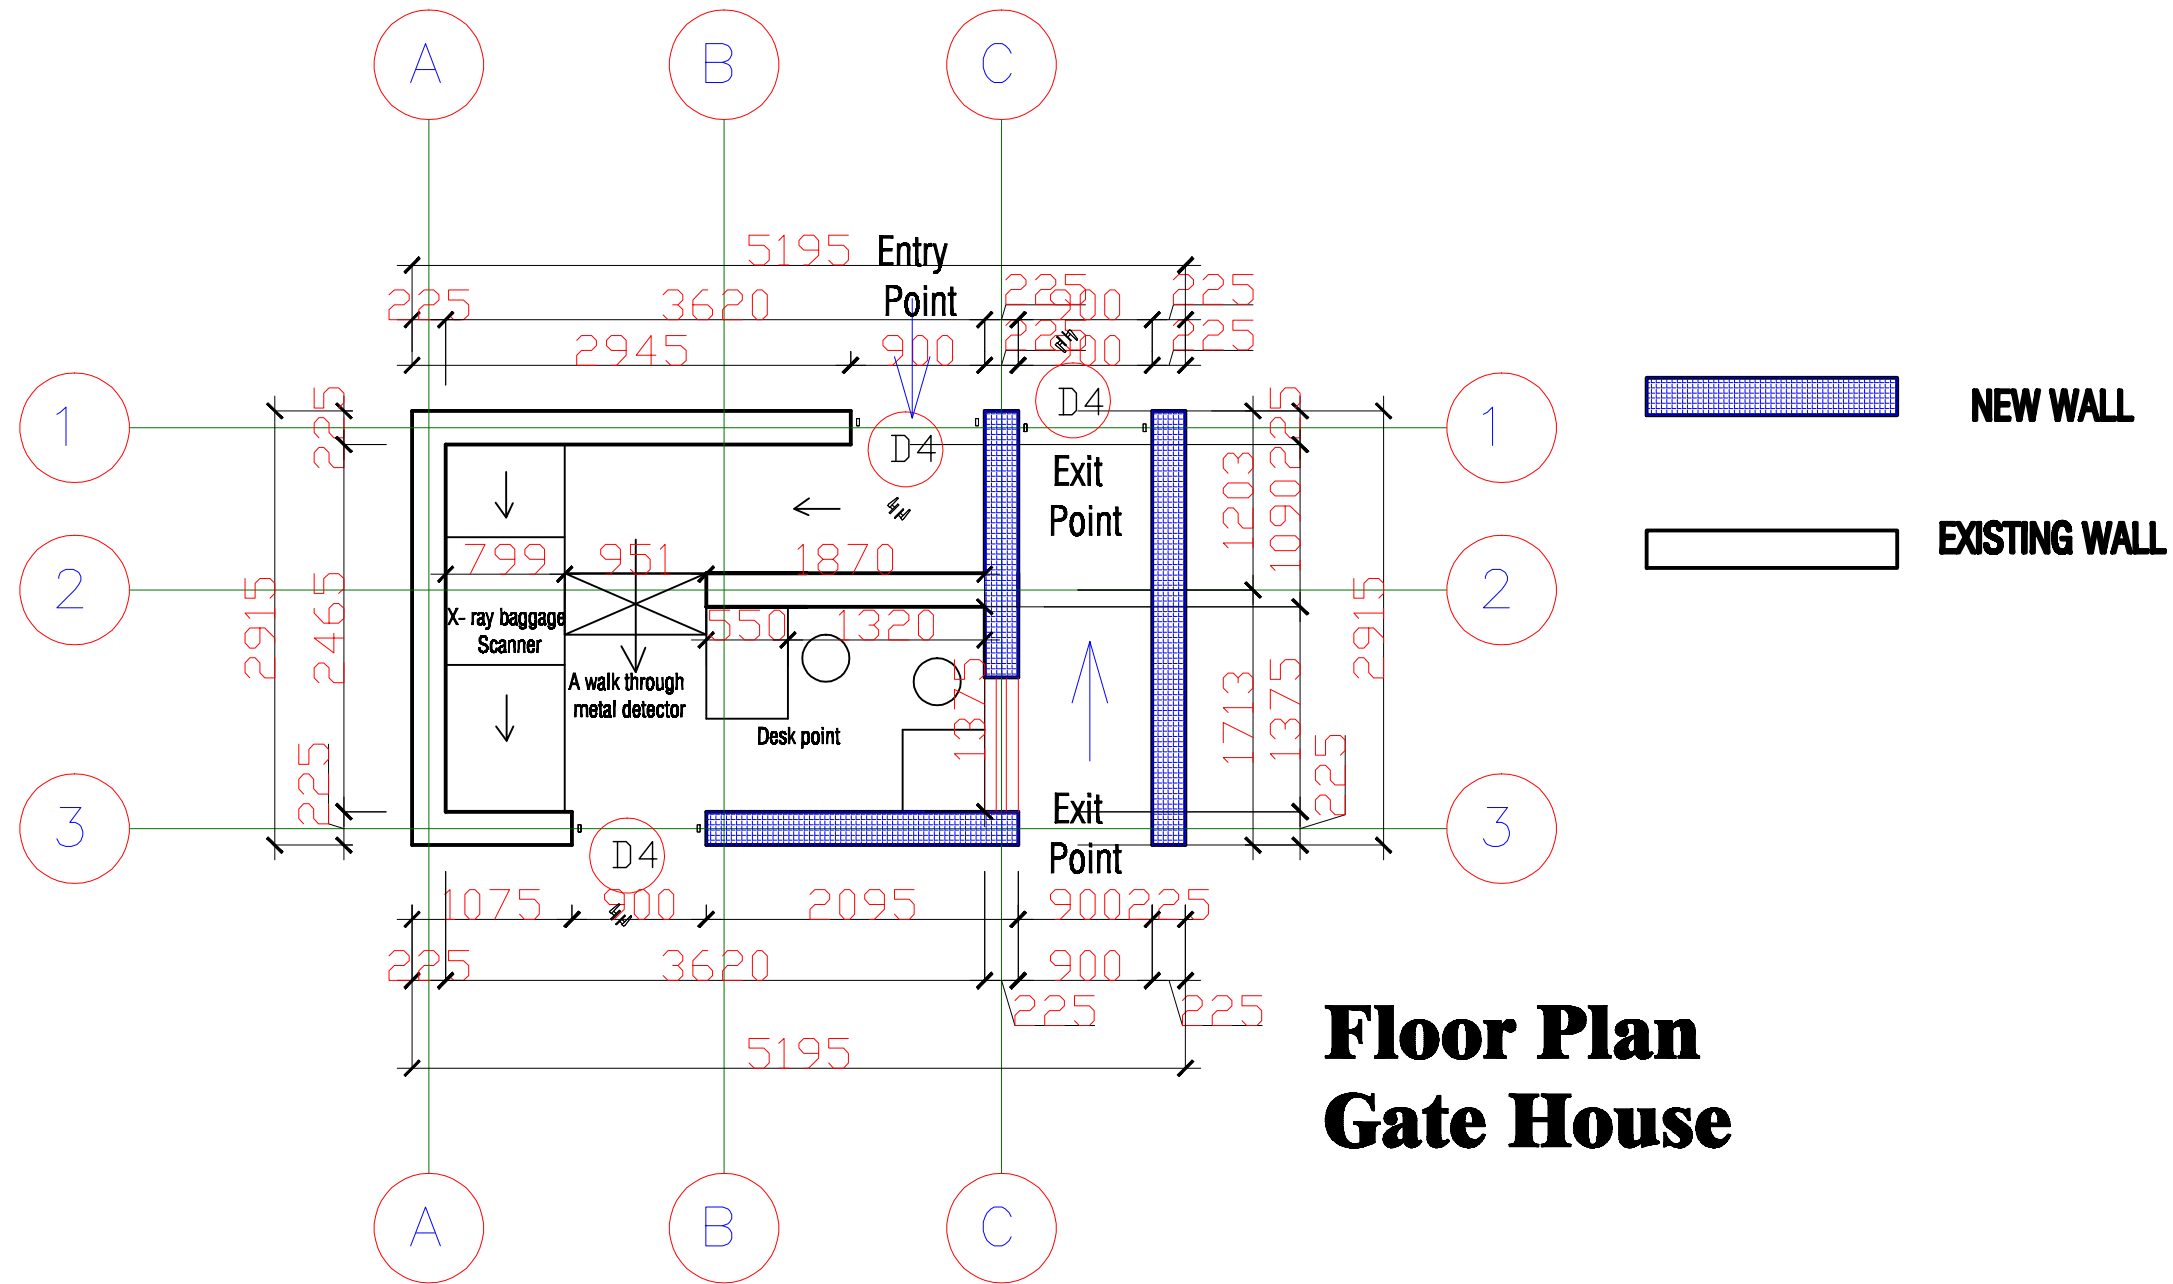

Floor Plan Gate House

AS PROPOSED

NOTES - Where there is any discrepancy(ies) between Architectural drawings and other contract documents, the architectural drawings takes precedence. The Architect must be notified before any implementation.

- Figured dimensions must be taken in preference to scaled dimensions.
- All timber to be pressure treated with anti-fungal and anti-infestation or approved formula.
- Contractors, sub-contractors and suppliers must verify all dimensions on site before commencing any works or producing any shop drawings.
- Copyright reserved by **MORPHOSIS INC.**

Consultant



MORPHOSIS
INC
LTD

4, Mole Crescent, Alimosho, Lagos.
E-mail: layladipo@yahoo.com
morphosisincld@yahoo.com
Telephone: Tel-0803 2078245, 7748804

Client

**INTERNATIONAL ORGANIZATION FOR
MIGRATION (IOM)**

Project

**AS BUILT DRAWING FOR PROPOSED
RENOVATION IOMAC BUILDING AT NO. 55
HASSAN USMAN KASTINA STREET
ASOKORO, ABUJA**

Drawn	Paul Emmanuel	
Checked	Arc. Layl LADIPO	Date
Scale	1:100	APRIL 2022
Revision		

Drawing Title:

FLOOR PLAN

Sheet no:

004